

Date: Monday, 4/10/2006 11:12:50 AM
 User: Kim Johnston

Process Sheet

Customer	: CU-DAR001 Dart Helicopters Services	Drawing Name	: TUBE
Job Number	: 26598		
Estimate Number	: 12243		
P.O. Number	: N/A	Part Number	: D34773
This Issue	: 4/10/2006 S.O. No. : N/A	Drawing Number	: D3477 REV A
Prsht Rev.	: NC	Project Number	: N/A
First Issue	: N/A Type : PURCHASED PARTS	Drawing Revision	: A
Previous Run	: 26285	Material	: N/A
Written By	: SEE COMMENT BELOW	Due Date	: 4/28/2006 Qty: 1 Um: Each
Checked & Approved By	: 06.04.10		
Comment	: Est Rev:A New Issue 06-02-07 JLM		

Additional Product

Job Number:



Seq. #:	Machine Or Operation:	Description :
---------	-----------------------	---------------

1.0	M304S26GA	304/316 0.018 SHEET
-----	-----------	---------------------



Comment: Qty.: 0.1985 sf(s)/Unit Total : 0.1985 sf(s)
 304/316 0.018 SHEET
 (M304S26GA)
 Batch: M19704

SB 06/04/17

⑧

2.0	SHEAR	SHEAR
-----	-------	-------



Comment: SHEAR

Cut as per Dwg D3477 (13.40" X 2.04")

SB 06/04/17

⑧

3.0	SMALL FAB 1	SMALL & MEDIUM FAB RESOURCE 1
-----	-------------	-------------------------------



Comment: SMALL & MEDIUM FAB RESOURCE 1

1-Deburr

2-Roll as per Dwg D3477

3-Tack Weld as per Dwg D3477

SB 06/04/17

⑧

4.0	QC5/9	WELD INSPECTION
-----	-------	-----------------



PD 06-04

Comment: WELD INSPECTION

06.04.17

⑧

W/O:		WORK ORDER CHANGES					
DATE	STEP	PROCEDURE CHANGE	By	Date	Qty	Approval Chief Eng / Prod Mgr	Approval QC Inspector

Part No: _____ PAR #: _____ Fault Category: _____ NCR: Yes No DQA: _____ Date: _____

QA: N/C Closed: _____ Date: _____

NCR:		WORK ORDER NON-CONFORMANCE (NCR)						
DATE	STEP	Description of NC Section A	Corrective Action Section B			Verification Section C	Approval Chief Eng	Approval QC Inspector
			Initial Chief Eng	Action Description Chief Eng	Sign & Date			

NOTE: Date & initial all entries

Date: Monday, 4/10/2006 11:12:50 AM
User: Kim Johnston

Process Sheet

Customer: CU-DAR001 Dart Helicopters Services

Drawing Name: TUBE

Job Number: 26598

Part Number: D34773

Job Number:



Seq. #:

Machine Or Operation:

Description :

5.0

PACKAGING 1

PACKAGING RESOURCE #1



Comment: PACKAGING RESOURCE #1

Identify and Stock

Location: GA

SB 06/04/19 (S)

6.0

DC

DOCUMENT CONTROL



Comment: DOCUMENT CONTROL

Inspection Level 21

DP 06/04/19

Job Completion



1 06-24-18

Dart Aerospace Ltd

W/O:		WORK ORDER CHANGES					
DATE	STEP	PROCEDURE CHANGE	By	Date	Qty	Approval Chief Eng / Prod Mgr	Approval QC Inspector

Part No: _____ PAR #: _____ Fault Category: _____ NCR: Yes No DQA: _____ Date: _____

QA: N/C Closed: _____ Date: _____

NCR:		WORK ORDER NON-CONFORMANCE (NCR)						
DATE	STEP	Description of NC Section A	Corrective Action Section B			Verification Section C	Approval Chief Eng	Approval QC Inspector
			Initial Chief Eng	Action Description Chief Eng	Sign & Date			

NOTE: Date & initial all entries

DART

DESIGN <i>B</i>	DRAWN BY <i>B</i>	DART AEROSPACE LTD HAWKESBURY, ONTARIO, CANADA	
CHECKED <i>H</i>	APPROVED <i>H</i>	DRAWING NO. D3477	REV. A SHEET 1 OF 4
DATE 05.12.09		TITLE BLOWER INLET ADAPTER	SCALE 1:2
A	05.12.09	NEW ISSUE	

*# 06.04.03*D3477-5 BLOWER
ADAPTER FLANGE (1)D3477-3
TUBE (1)D3477-1
FLANGE (1)ALIGNMENT OF
SPOT WELD SEAM $\phi 7.13$
(REF)

30°

45°

30°

(2 PLACES)

0.50
(24)

SHOP COPY
RETURN TO
ENGINEERING
UNCONTROLLED COPY
SUBJECT TO AMENDMENT
WITHOUT NOTICE
WORK ORDER
NO. **26598**

D3477-041 BLOWER MOTOR INLET ADAPTER**NOTES:**

- 1) SPOT WELD PER DART QSI 004
- 2) FINISH: NONE
- 3) IDENTIFY WITH DART P/N D3477-041 USING FINE POINT PERMANENT INK MARKER
- 4) TOLERANCES ARE PER DART QSI 018 UNLESS OTHERWISE NOTED
- 5) ALL DIMENSIONS ARE IN INCHES
- 6) BREAK ALL SHARP EDGES 0.005 TO 0.010

QTY -041	P/N	DESCRIPTION
X	D3477-041	BLOWER MOTOR ASSEMBLY
1	D3477-1	FLANGE
1	D3477-3	TUBE
1	D3477-5	BLOWER ADAPTER FLANGE


COPYRIGHT © 2005 BY DART AEROSPACE LTD.

THIS DOCUMENT IS PRIVATE AND CONFIDENTIAL AND IS SUPPLIED ON THE EXPRESS CONDITION THAT IT IS NOT TO BE USED FOR ANY PURPOSE OR COPIED OR COMMUNICATED TO ANY OTHER PERSON WITHOUT WRITTEN PERMISSION FROM DART AEROSPACE LTD.




DESIGN <i>[Signature]</i>	DRAWN BY <i>[Signature]</i>	DART AEROSPACE LTD HAWKESBURY, ONTARIO, CANADA	
CHECKED <i>[Signature]</i>	APPROVED <i>[Signature]</i>	DRAWING NO. D3477	REV. A SHEET 2 OF 4
DATE 05.12.09		TITLE BLOWER INLET ADAPTER	SCALE 1:2

06.04.03

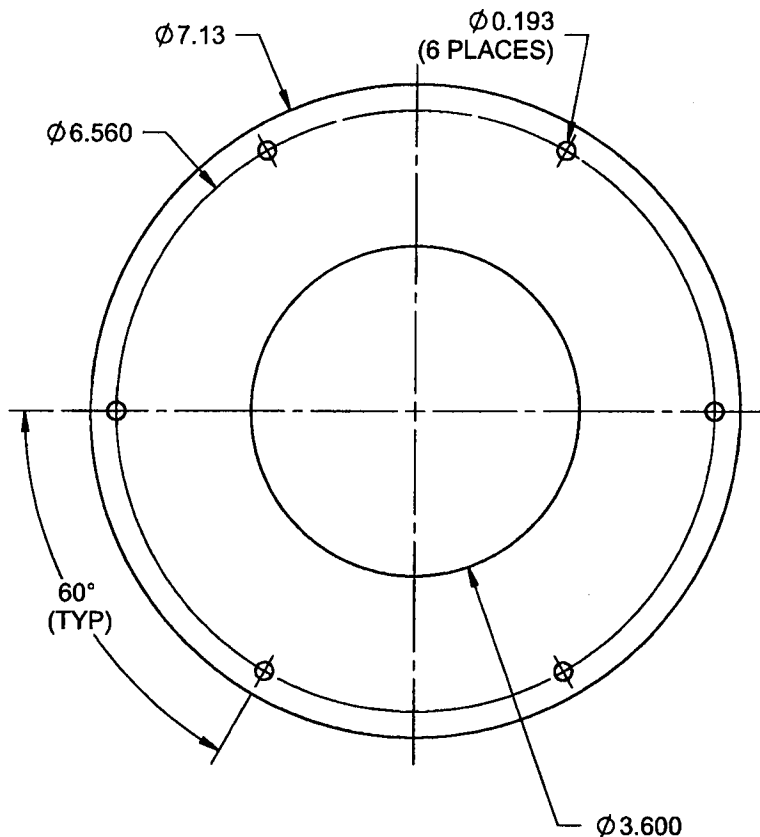

**D3477-1F FLANGE
FLAT PATTERN**

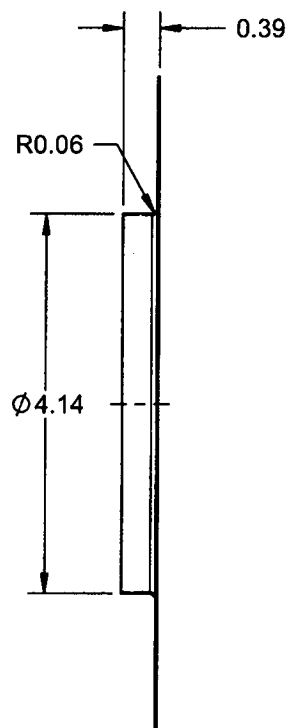

**D3477-1
FLANGE**

NOTES:

- 1) MATERIAL: AISI 304/316 SS SHEET PER MIL-S-5019 (ANNEALED) 2B FINISH
26 GAUGE SS (0.018 THICK)
(REF. DART SPEC. M304S26GA)
- 2) TOLERANCES ARE PER DART QSI 018 UNLESS OTHERWISE NOTED
- 3) ALL DIMENSIONS ARE IN INCHES
- 4) BREAK ALL SHARP EDGES 0.005 TO 0.010





SHOP COPY
RETURN TO
ENGINEERING
UNCONTROLLED COPY
SUBJECT TO AMENDMENT
WITHOUT NOTICE
WORK ORDER
NO. 26598

COPYRIGHT © 2005 BY DART AEROSPACE LTD.

THIS DOCUMENT IS PRIVATE AND CONFIDENTIAL AND IS SUPPLIED ON THE EXPRESS CONDITION THAT IT IS NOT TO BE USED FOR ANY PURPOSE OR COPIED OR COMMUNICATED TO ANY OTHER PERSON WITHOUT WRITTEN PERMISSION FROM DART AEROSPACE LTD.

DART

DESIGN <i>[Signature]</i>	DRAWN BY <i>[Signature]</i>	DART AEROSPACE LTD HAWKESBURY, ONTARIO, CANADA	
CHECKED <i>[Signature]</i>	APPROVED <i>[Signature]</i>	DRAWING NO. D3477	REV. A SHEET 3 OF 4
DATE 05.12.09		TITLE BLOWER INLET ADAPTER	SCALE 1:2

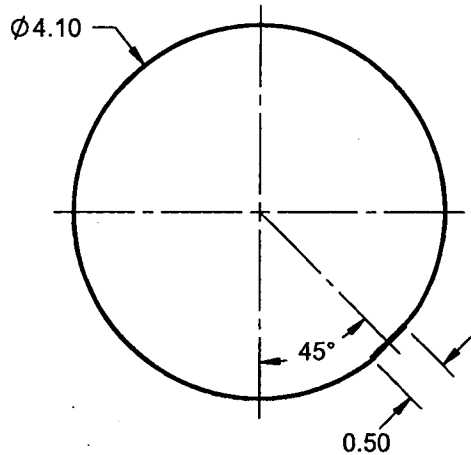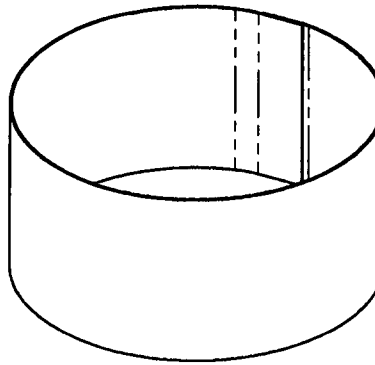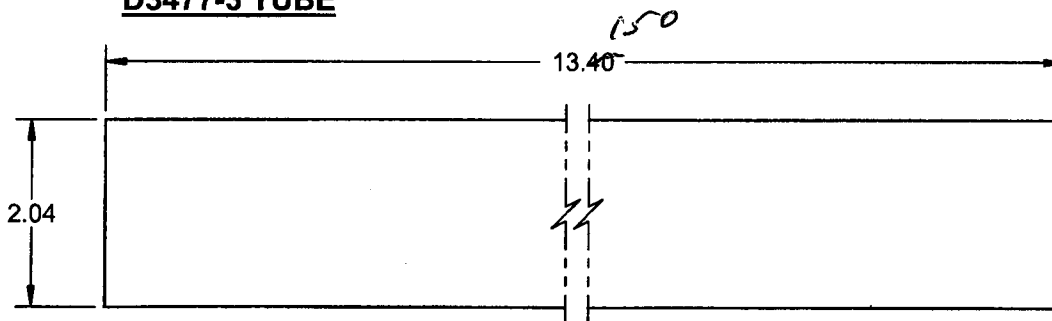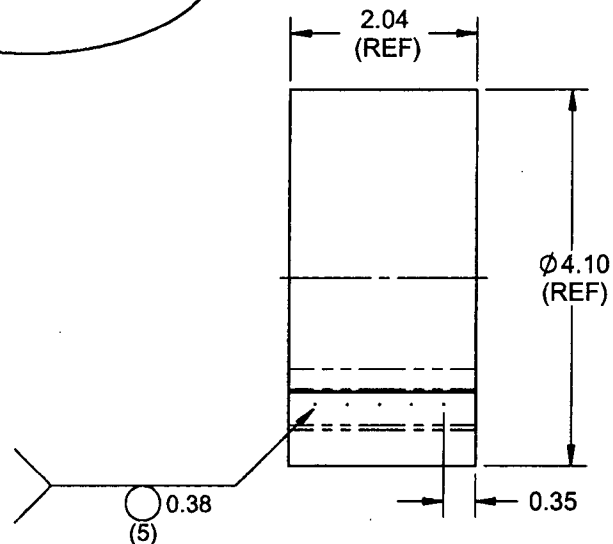[Signature] 06.04.03**D3477-3 TUBE****D3477-3F TUBE FLAT PATTERN****NOTES:**

- 1) MATERIAL: AISI 304/316 SS SHEET PER MIL-S-5019 (ANNEALED) 2B FINISH, 26 GAUGE SS (0.018 THICK) (REF. DART SPEC. M304S26GA)
- 2) WELD PER DART QSI 004
- 3) TOLERANCES ARE PER DART QSI 018 UNLESS OTHERWISE NOTED
- 4) ALL DIMENSIONS ARE IN INCHES
- 5) BREAK ALL SHARP EDGES 0.005 TO 0.010

SHOP COPY
RETURN TO
ENGINEERING
CONTROLLED COPY
SUBJECT TO AMENDMENT
WITHOUT NOTICE
WORK ORDER
NO. 26598


COPYRIGHT © 2005 BY DART AEROSPACE LTD.

THIS DOCUMENT IS PRIVATE AND CONFIDENTIAL AND IS SUPPLIED ON THE EXPRESS CONDITION THAT IT IS NOT TO BE USED FOR ANY PURPOSE OR COPIED OR COMMUNICATED TO ANY OTHER PERSON WITHOUT WRITTEN PERMISSION FROM DART AEROSPACE LTD.




DESIGN <i>[Signature]</i>	DRAWN BY <i>[Signature]</i>	DART AEROSPACE LTD HAWKESBURY, ONTARIO, CANADA	
CHECKED <i>[Signature]</i>	APPROVED <i>[Signature]</i>	DRAWING NO. D3477	REV. A SHEET 4 OF 4
DATE 05.12.09		TITLE BLOWER INLET ADAPTER	SCALE 1:2

06.04.03

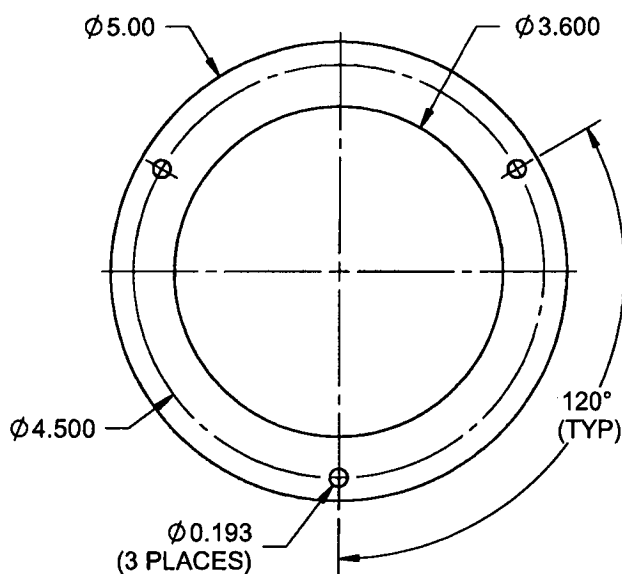

D3477-5F FLAT PATTERN

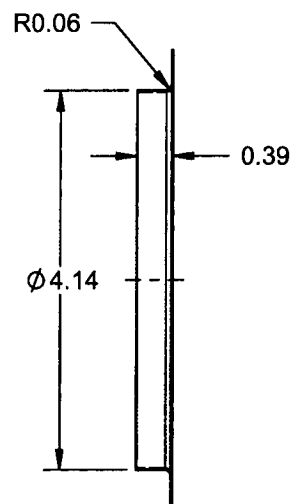

**D3477-5 BLOWER
ADAPTER FLANGE**

NOTES:

- 1) MATERIAL: AISI 304/316 SS SHEET PER MIL-S-5019 (ANNEALED) 2B FINISH
26 GAUGE SS (0.018 THICK)
(REF. DART SPEC. M304S26GA)
- 2) TOLERANCES ARE PER DART QSI 018 UNLESS OTHERWISE NOTED
- 3) ALL DIMENSIONS ARE IN INCHES
- 4) BREAK ALL SHARP EDGES 0.005 TO 0.010

SHOP COPY
RETURN TO
ENGINEERING
UNCONTROLLED COPY
SUBJECT TO AMENDMENT
WITHOUT NOTICE
WORK ORDER
NO. *26598*

COPYRIGHT © 2005 BY DART AEROSPACE LTD.

THIS DOCUMENT IS PRIVATE AND CONFIDENTIAL AND IS SUPPLIED ON THE EXPRESS CONDITION THAT IT IS NOT TO BE USED FOR ANY PURPOSE OR COPIED OR COMMUNICATED TO ANY OTHER PERSON WITHOUT WRITTEN PERMISSION FROM DART AEROSPACE LTD.